



RESIDENTIAL PROPERTY DISCLOSURE STATEMENT SELLER AND PURCHASER ACKNOWLEDGEMENT FORM


The Virginia Residential Property Disclosure Act (§ 55.1-700 et seq. of the *Code of Virginia*) requires the owner of certain residential real property whenever the property is to be sold or leased with an option to buy to provide notification to the purchaser of disclosures required by the Act and to advise the purchaser that the disclosures are listed on the Real Estate Board webpage.

Certain transfers of residential property are excluded from this requirement (see § 55.1-702).

700 W Washington Street
PROPERTY ADDRESS/ Middleburg, VA 20117
LEGAL DESCRIPTION:

The purchaser is advised of the disclosures listed in the RESIDENTIAL PROPERTY DISCLOSURE STATEMENT located on the Real Estate Board webpage at:
http://www.dpor.virginia.gov/Consumers/Residential_Property_Disclosures

The owner(s) hereby provides notification as required under the Virginia Residential Property Disclosure Act (§ 55.1-700 et seq. of the *Code of Virginia*) and, if represented by a real estate licensee as provided in § 55.1-712, further acknowledges having been informed of the rights and obligations under the Act.

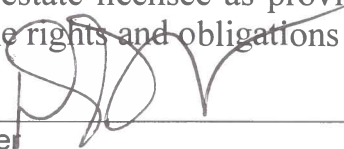
Owner

Daree Goodman


Date

Owner

Date

The purchaser(s) hereby acknowledges receipt of notification of disclosures as required under the Virginia Residential Property Disclosure Act (§ 55.1-700 et seq. of the *Code of Virginia*). In addition, if the purchaser is (i) represented by a real estate licensee or (ii) not represented by a real estate licensee but the owner is so represented as provided in § 55.1-712, the purchaser further acknowledges having been informed of the rights and obligations under the Act.

Purchaser

Purchaser

Date

Date

SALE: DISCLOSURE AND ACKNOWLEDGMENT OF INFORMATION ON LEAD-BASED PAINT AND/OR LEAD-BASED PAINT HAZARDS

For the sale of the Property at: **700 W Washington Street, Middleburg, VA 20117**

Lead Warning Statement

Every purchaser of any interest in residential real property on which a residential dwelling was built prior to 1978 is notified that such property may present exposure to lead from lead-based paint that may place young children at risk of developing lead poisoning. Lead poisoning in young children may produce permanent neurological damage, including learning disabilities, reduced intelligence quotient, behavioral problems, and impaired memory. Lead poisoning also poses a particular risk to pregnant women. The seller of any interest in residential real property is required to provide the buyer with any information on lead-based paint hazards from risk assessments or inspections in the seller's possession and notify the buyer of any known lead-based paint hazards. A risk assessment or inspection for possible lead-based paint hazards is recommended prior to purchase.

Seller's Disclosure (initial)

- ____ / DS (a) Presence of lead-based paint and/or lead-based paint hazard (check one below):
 Known lead-based paint and/or lead-based paint hazards are present in the housing (explain):

- ____ / DS Seller has no knowledge of lead-based paint and/or lead-based paint hazards in the housing.
 (b) Records and Reports available to the seller (check one below):
 Seller has provided the purchaser with all available records and reports pertaining to lead-based paint and/or lead-based paint hazards in the housing (list documents below):

- Seller has no reports or records pertaining to lead-based paint and/or lead-based paint hazards in the housing.

Purchaser's Acknowledgment (initial)

- ____ / _____ (c) Purchaser has received and had an opportunity to review copies of all information listed above.
 ____ / _____ (d) Purchaser has received the pamphlet *Protect Your Family From Lead in Your Home*.
 ____ / _____ (e) Purchaser has (check one below):
 Received a 10-day opportunity (or mutually agreed upon period) to conduct a risk assessment or inspection for the presence of lead-based paint or lead-based paint hazards; or
 Waived the opportunity to conduct a risk assessment or inspection for the presence of lead-based paint and/or lead-based paint hazards.

Sales Associates' Acknowledgments (initial)

- ____ / MM (f) Listing and Selling Sales Associates are aware of their duty to ensure compliance with 42 U.S.C. 4852d. These Associates have informed the Seller of the Seller's obligations under this law as evidenced by Seller and Purchaser having completed this form.

Certification of Accuracy

The undersigned have reviewed the information above and certify that to the best of their knowledge the information they have provided is true and accurate.

SELLER:
 3/26/24 / DS
 Date Signature
Daree Goodman

____ / _____
 Date Signature
 3/26/24 / Paul MacMahon
 Date Signature of Listing Associate
Paul MacMahon

PURCHASER:
 _____ / _____
 Date Signature

____ / _____
 Date Signature
 _____ / _____
 Date Signature of Selling Associate

© 2008 Northern Virginia Association of REALTORS®, Inc.




This is a suggested form of the Northern Virginia Association of REALTORS®, Inc. ("NVAR"). This form has been exclusively printed for the use of REALTOR® and Non-Resident members of NVAR, who may copy or otherwise reproduce this form in identical form with the addition of their company logo. Any other use of this form by REALTOR® and Non-Resident members of NVAR, or any use of this form whatsoever by non-members of NVAR is prohibited without the prior written consent of NVAR. Notwithstanding the above, no REALTOR® or Non-Resident member of NVAR, or any other person, may copy or otherwise reproduce this form for purposes of resale.



RECORD NORTH
INSTR. #200607210063032

TRACT B-2
ARMFIELD DIVISION

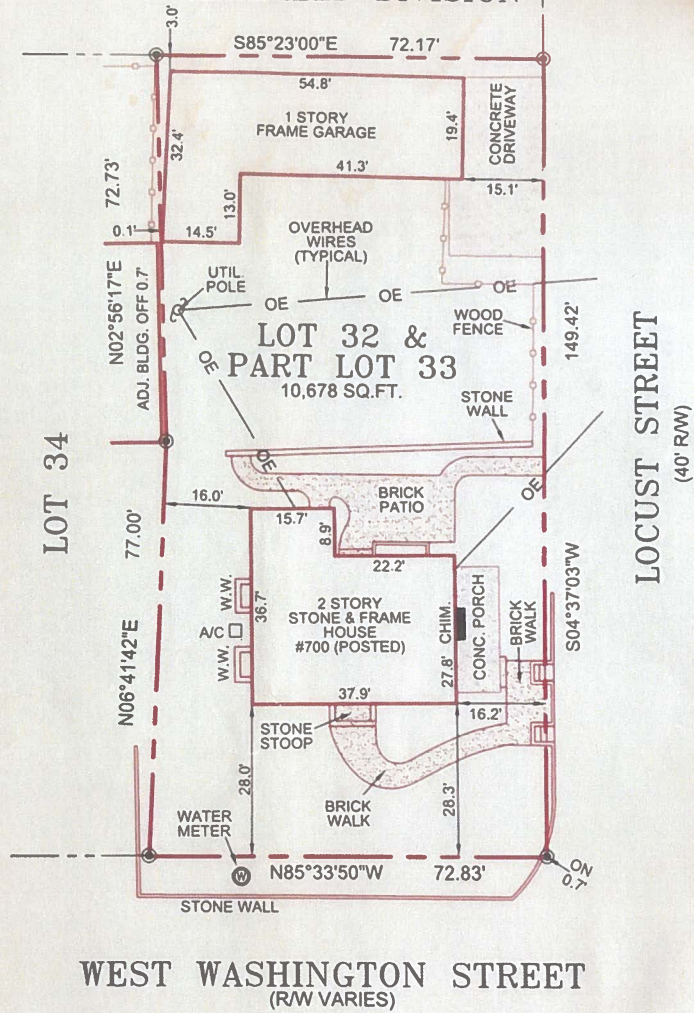

- 1) THIS PROPERTY IS SHOWN ON LOUDOUN COUNTY TAX ASSESSMENT PARCEL ID NO. 538-16-1152.
- 2) THE IMPROVEMENTS DELINEATED HEREON FALL ENTIRELY WITHIN ZONE "X" (AREAS OF MINIMAL FLOOD HAZARD) AS SHOWN ON FEMA FLOOD INSURANCE RATE MAP #51107C-0330E DATED: FEBRUARY 17, 2017.
- 3) THE IMPROVEMENTS SHOWN HEREON HAVE BEEN CAREFULLY ESTABLISHED BY A CURRENT SURVEY USING MODERN SURVEY METHODS AND UNLESS OTHERWISE SHOWN, THERE ARE NO VISIBLE ENCROACHMENTS.
- 4) FENCES SHOWN, IF ANY, ARE FOR INFORMATION ONLY AND DO NOT REFLECT OWNERSHIP.
- 5) NO TITLE REPORT FURNISHED. EASEMENTS MAY EXIST WHICH ARE NOT SHOWN HEREON.
- 6) IPF Ⓞ DENOTES IRON PIN FOUND.

PREPARED FOR
VESTA
SETTLEMENTS
FOR: GOODMAN


SCALE: 1" = 25'

MARCH 18, 2022

NO TITLE REPORT FURNISHED
THIS IS NOT A BOUNDARY SURVEY

PHYSICAL IMPROVEMENT SURVEY
LOT 32 & PART LOT 33
RIDGE VIEW

INSTRUMENT #200607210063032
BLUE RIDGE ELECTION DISTRICT
LOUDOUN COUNTY, VIRGINIA

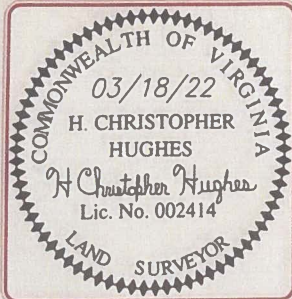

THIS SHEET IS USED FOR BOTH SURVEY & ARBORIST PURPOSES

BL SURVEY ARBORIST

BLSURVEYARBORIST@GMAIL.COM
GAINESVILLE VA

[PH] 703-624-4821

